





SPS TOWER

Minneapolis, Minnesota

SUITE 2830 - SUITE AS-BUILT PLAN (1,117 RSF)

1/8" = 1'-0"

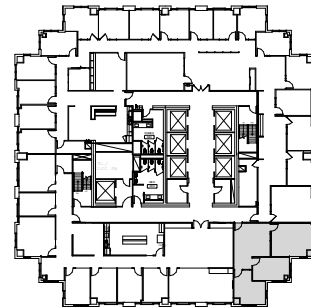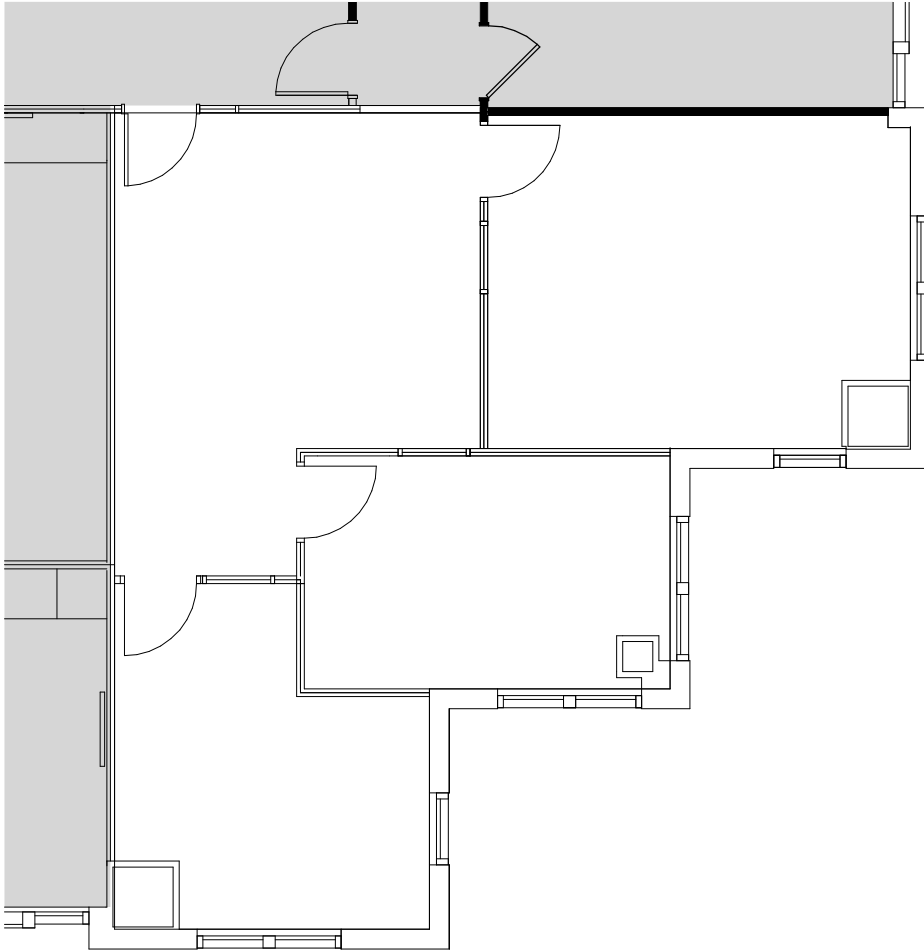

KEYPLAN

Leased by:



TRANSWESTERN[®]

NELSON

